

01
DET

Section View of Typical Horizontal Joint

North Clad®
rainscreen solutions


11831 BEVERLY PARK RD. BUILDING C, EVERETT, WA 98204
*PHONE: 425.740.3702 * FAX: 425.740.3701 *
www.northclad.com

This document is property of NorthClad and should not be used, duplicated or modified without the express written consent. Copyright © 2010
NorthClad All Rights Reserved

NO.	DESCRIPTION	DATE	INIT.
1	Orig Submittal	10/23/2014	M.E
2	Add Cascadia Clip	12/16/2014	M.E
3	As Built	02/16/2015	M.E
4			
5			
6			
7			
8			
9			
10			

Fiberesin NFPA 285 Test

Sheet Title	DET
Scale	3" = 1'-0"
Job Number	NC0001
Sheet	01
APPROVED	

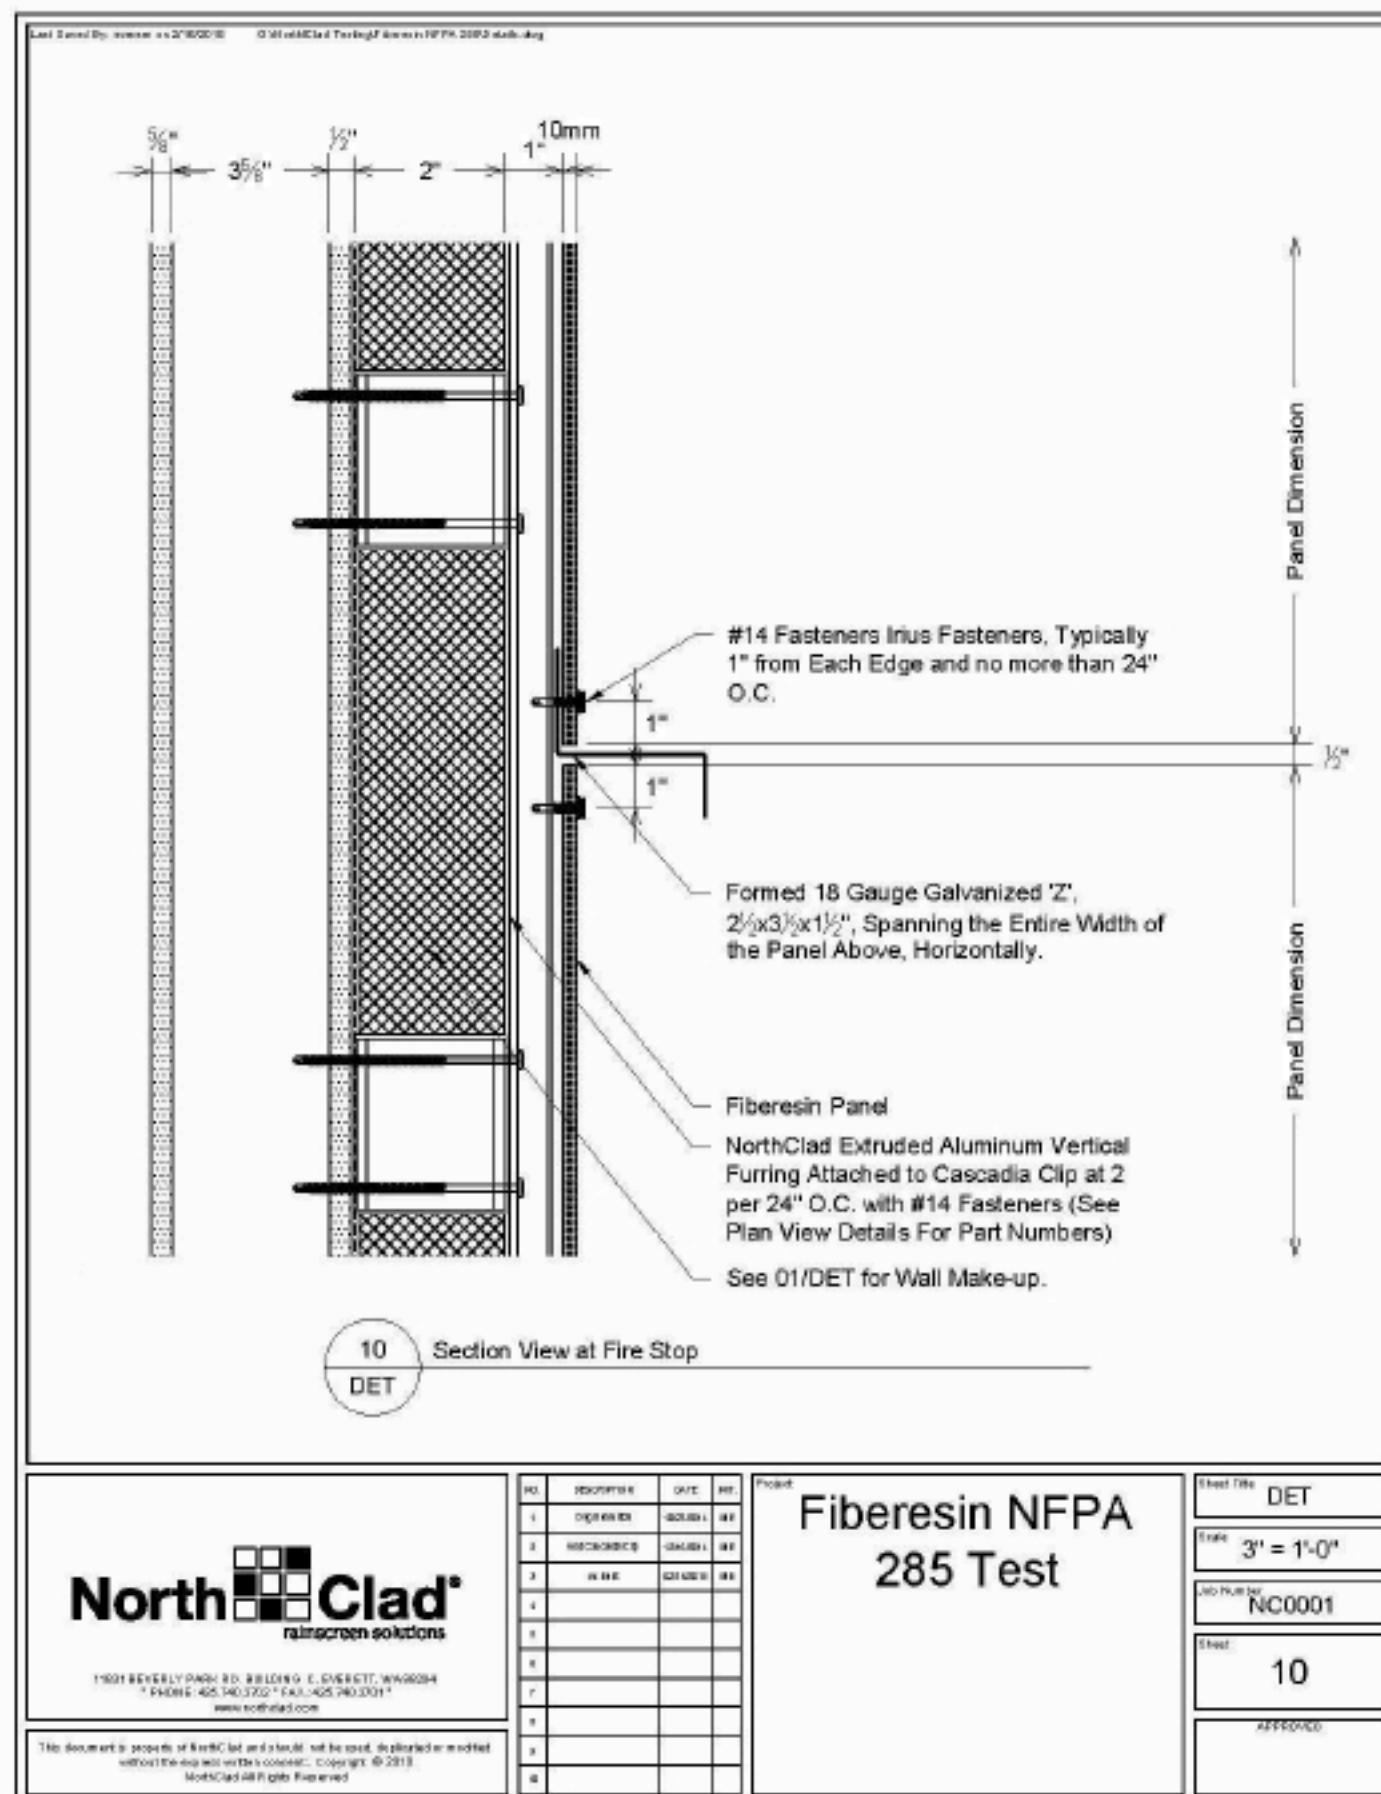

Fire stop is required 4' above window opening

